


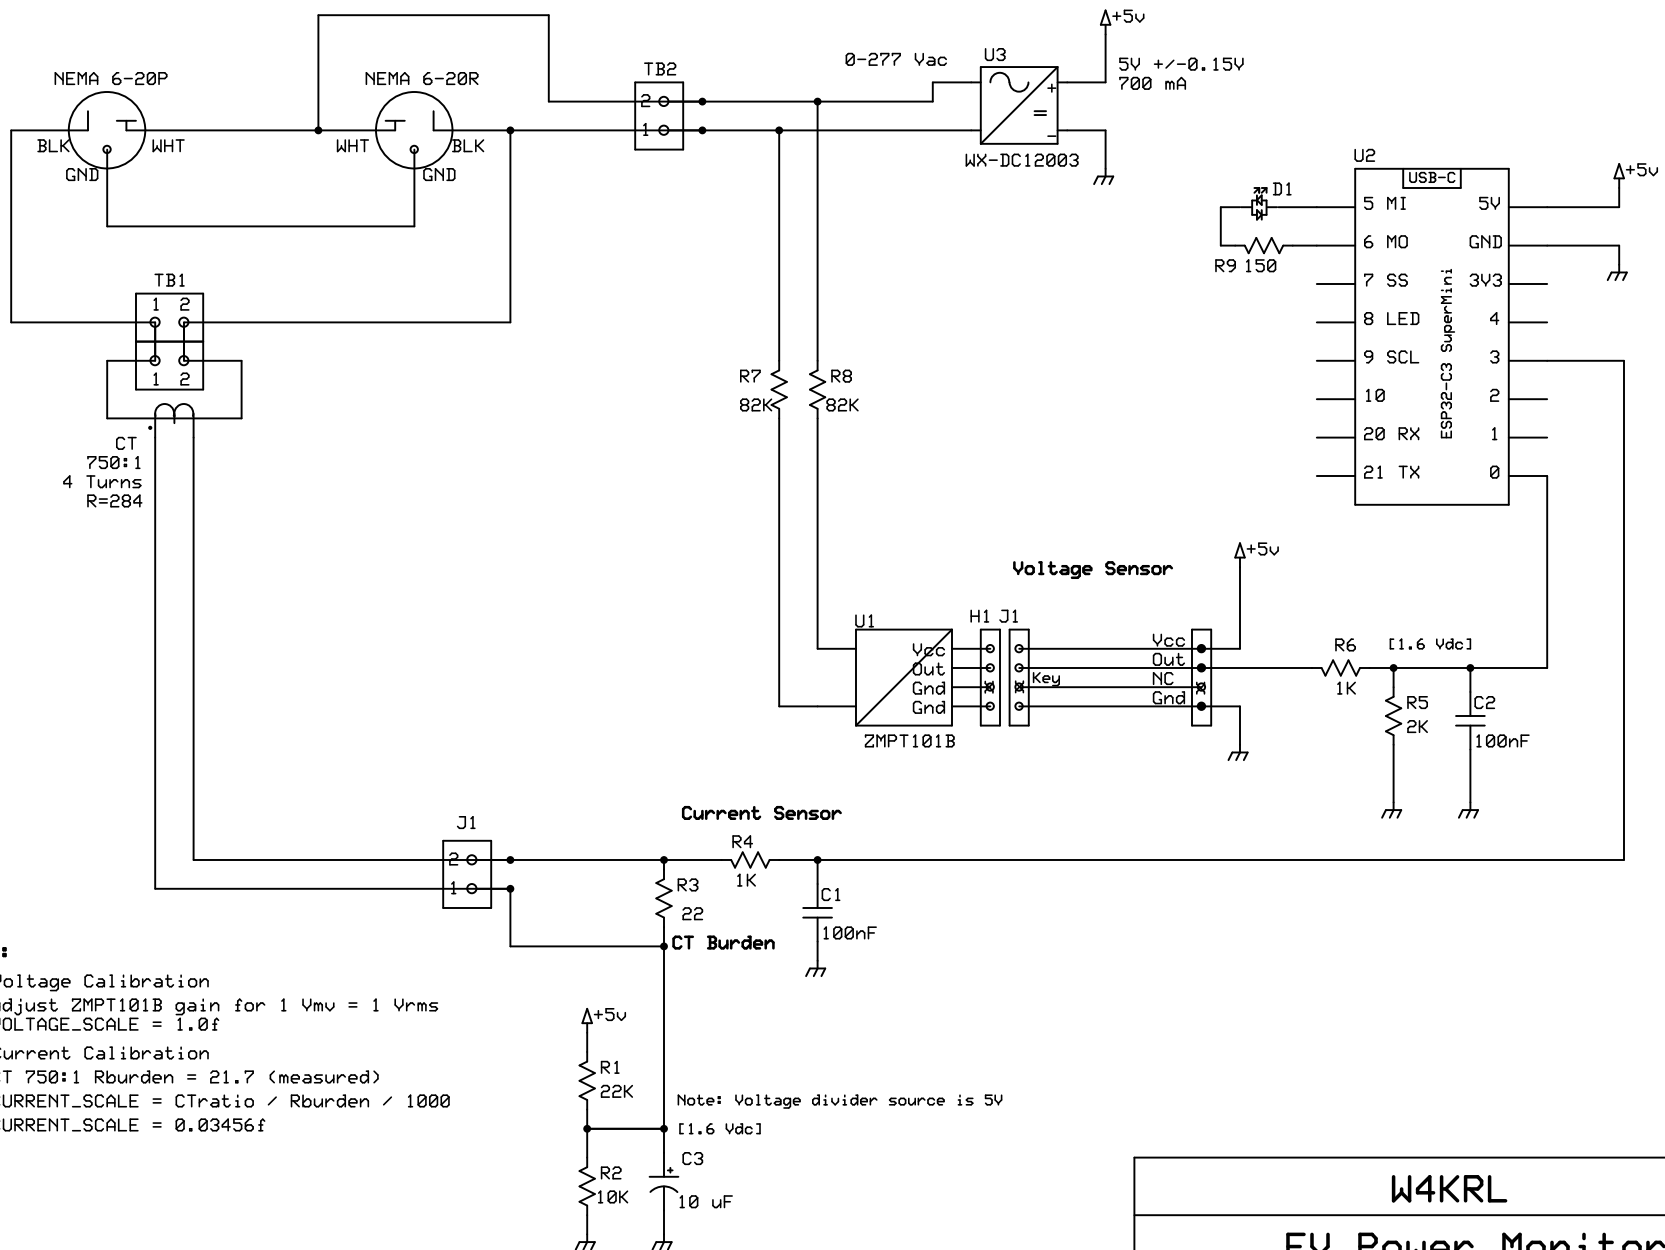

NOTES:

1. Voltage Calibration
Adjust ZMPT101B gain for 1 V_{mv} = 1 V_{rms}
VOLTAGE_SCALE = 1.0f
2. Current Calibration
CT 750:1 R_{burden} = 21.7 (measured)
CURRENT_SCALE = CTratio / R_{burden} / 1000
CURRENT_SCALE = 0.03456f

Note: Voltage divider source is 5V

W4KRL		
EV Power Monitor		
K W Berger	Rev 1.6	Page 1 of 2
	2026.07.09	